

5TH AVENUE 6TH AVENUE

WORK TO BE DONE




THE IMPROVEMENT CONSISTS OF THE FOLLOWING WORK TO BE DONE ACCORDING TO THESE PLANS AND SPECIFICATIONS, HERETO ATTACHED:

- THE CONSTRUCTION OF ASBESTOS CEMENT WATER MAINS AND APPURTENANCES AS SHOWN THUS: 8" AC 6" AC
- THE FURNISHING AND INSTALLING OF GALVANIZED IRON PIPE AS SHOWN THUS: 1" 2"
- THE FURNISHING AND INSTALLING OF HOSE BIBBS & RISERS AS SHOWN THUS: 1" 2"
- THE FURNISHING AND INSTALLING OF PRESSURE RELIEF VALVES AS SHOWN THUS: 1" 2"

ADDITIONAL WORK TO BE DONE SHOWN ON SHEET 1...

STANDARD DRAWINGS

702-EB, 205-WB, 212-WB, 240-WB, 231-WB, 238-WB, 243-WB, 402-WB, 224-WB, 761-B, 551-W

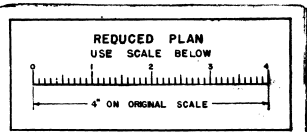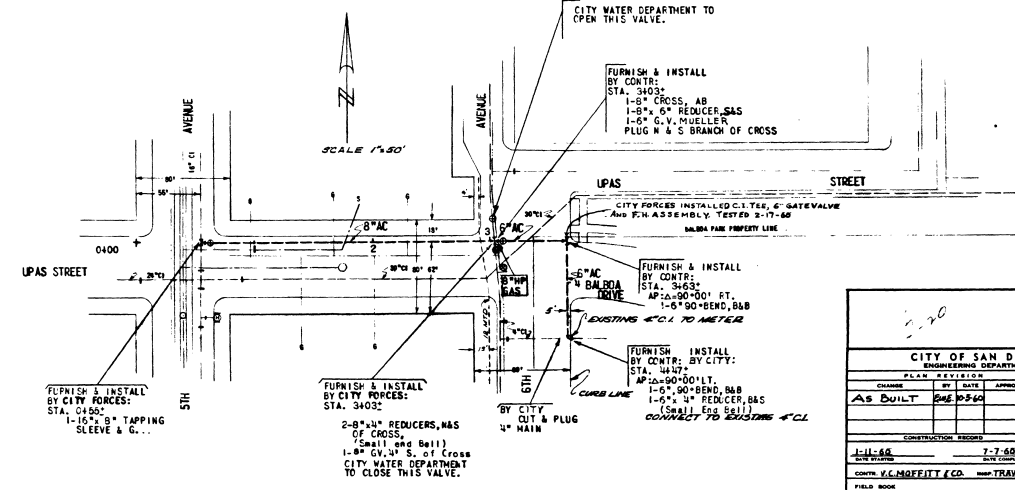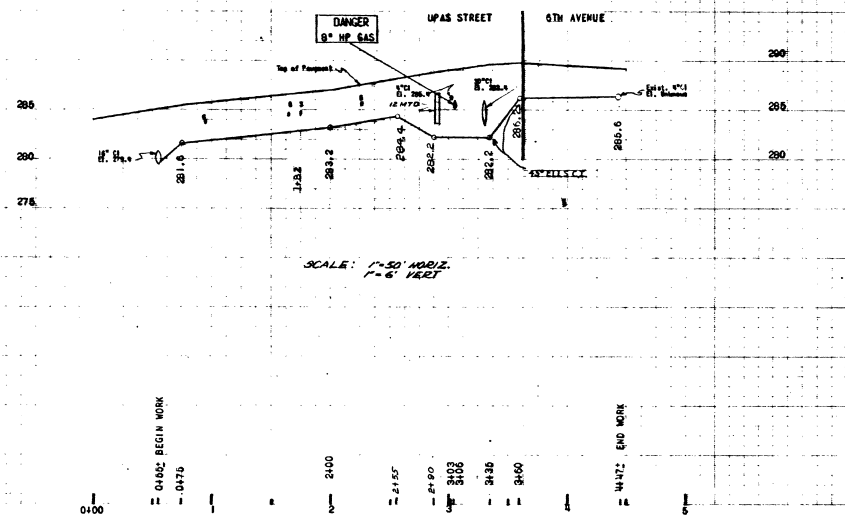

CITY OF SAN DIEGO				SHEET 2 OF 3 SHEETS		W.D. NO. 21725
ENGINEERING DEPARTMENT				APPROVALS FOR		DATE CITY ENGINEER HAS OFFICE DRAWN
PLAN	REVISION	BY	DATE	APPROVAL	DATE	
AS BUILT		DAE	10-20-60			
CONSTRUCTION RECORDS				ELECTRICAL		MECHANICAL
1-11-60				7-7-65		
COUNT: K.E. MOFFITT & CO.				TRAFFIC		
FIELD BOOK				CONTROL		